



AS-BUILT PLANS 12/12/12



6/18/2009 1:38:27 PM \\GDOT-DSN\GDPLOT\DCP\go_tiff_output.qcf gowens V:\GARY\REVISED S-7\S-7.prp G0-R06

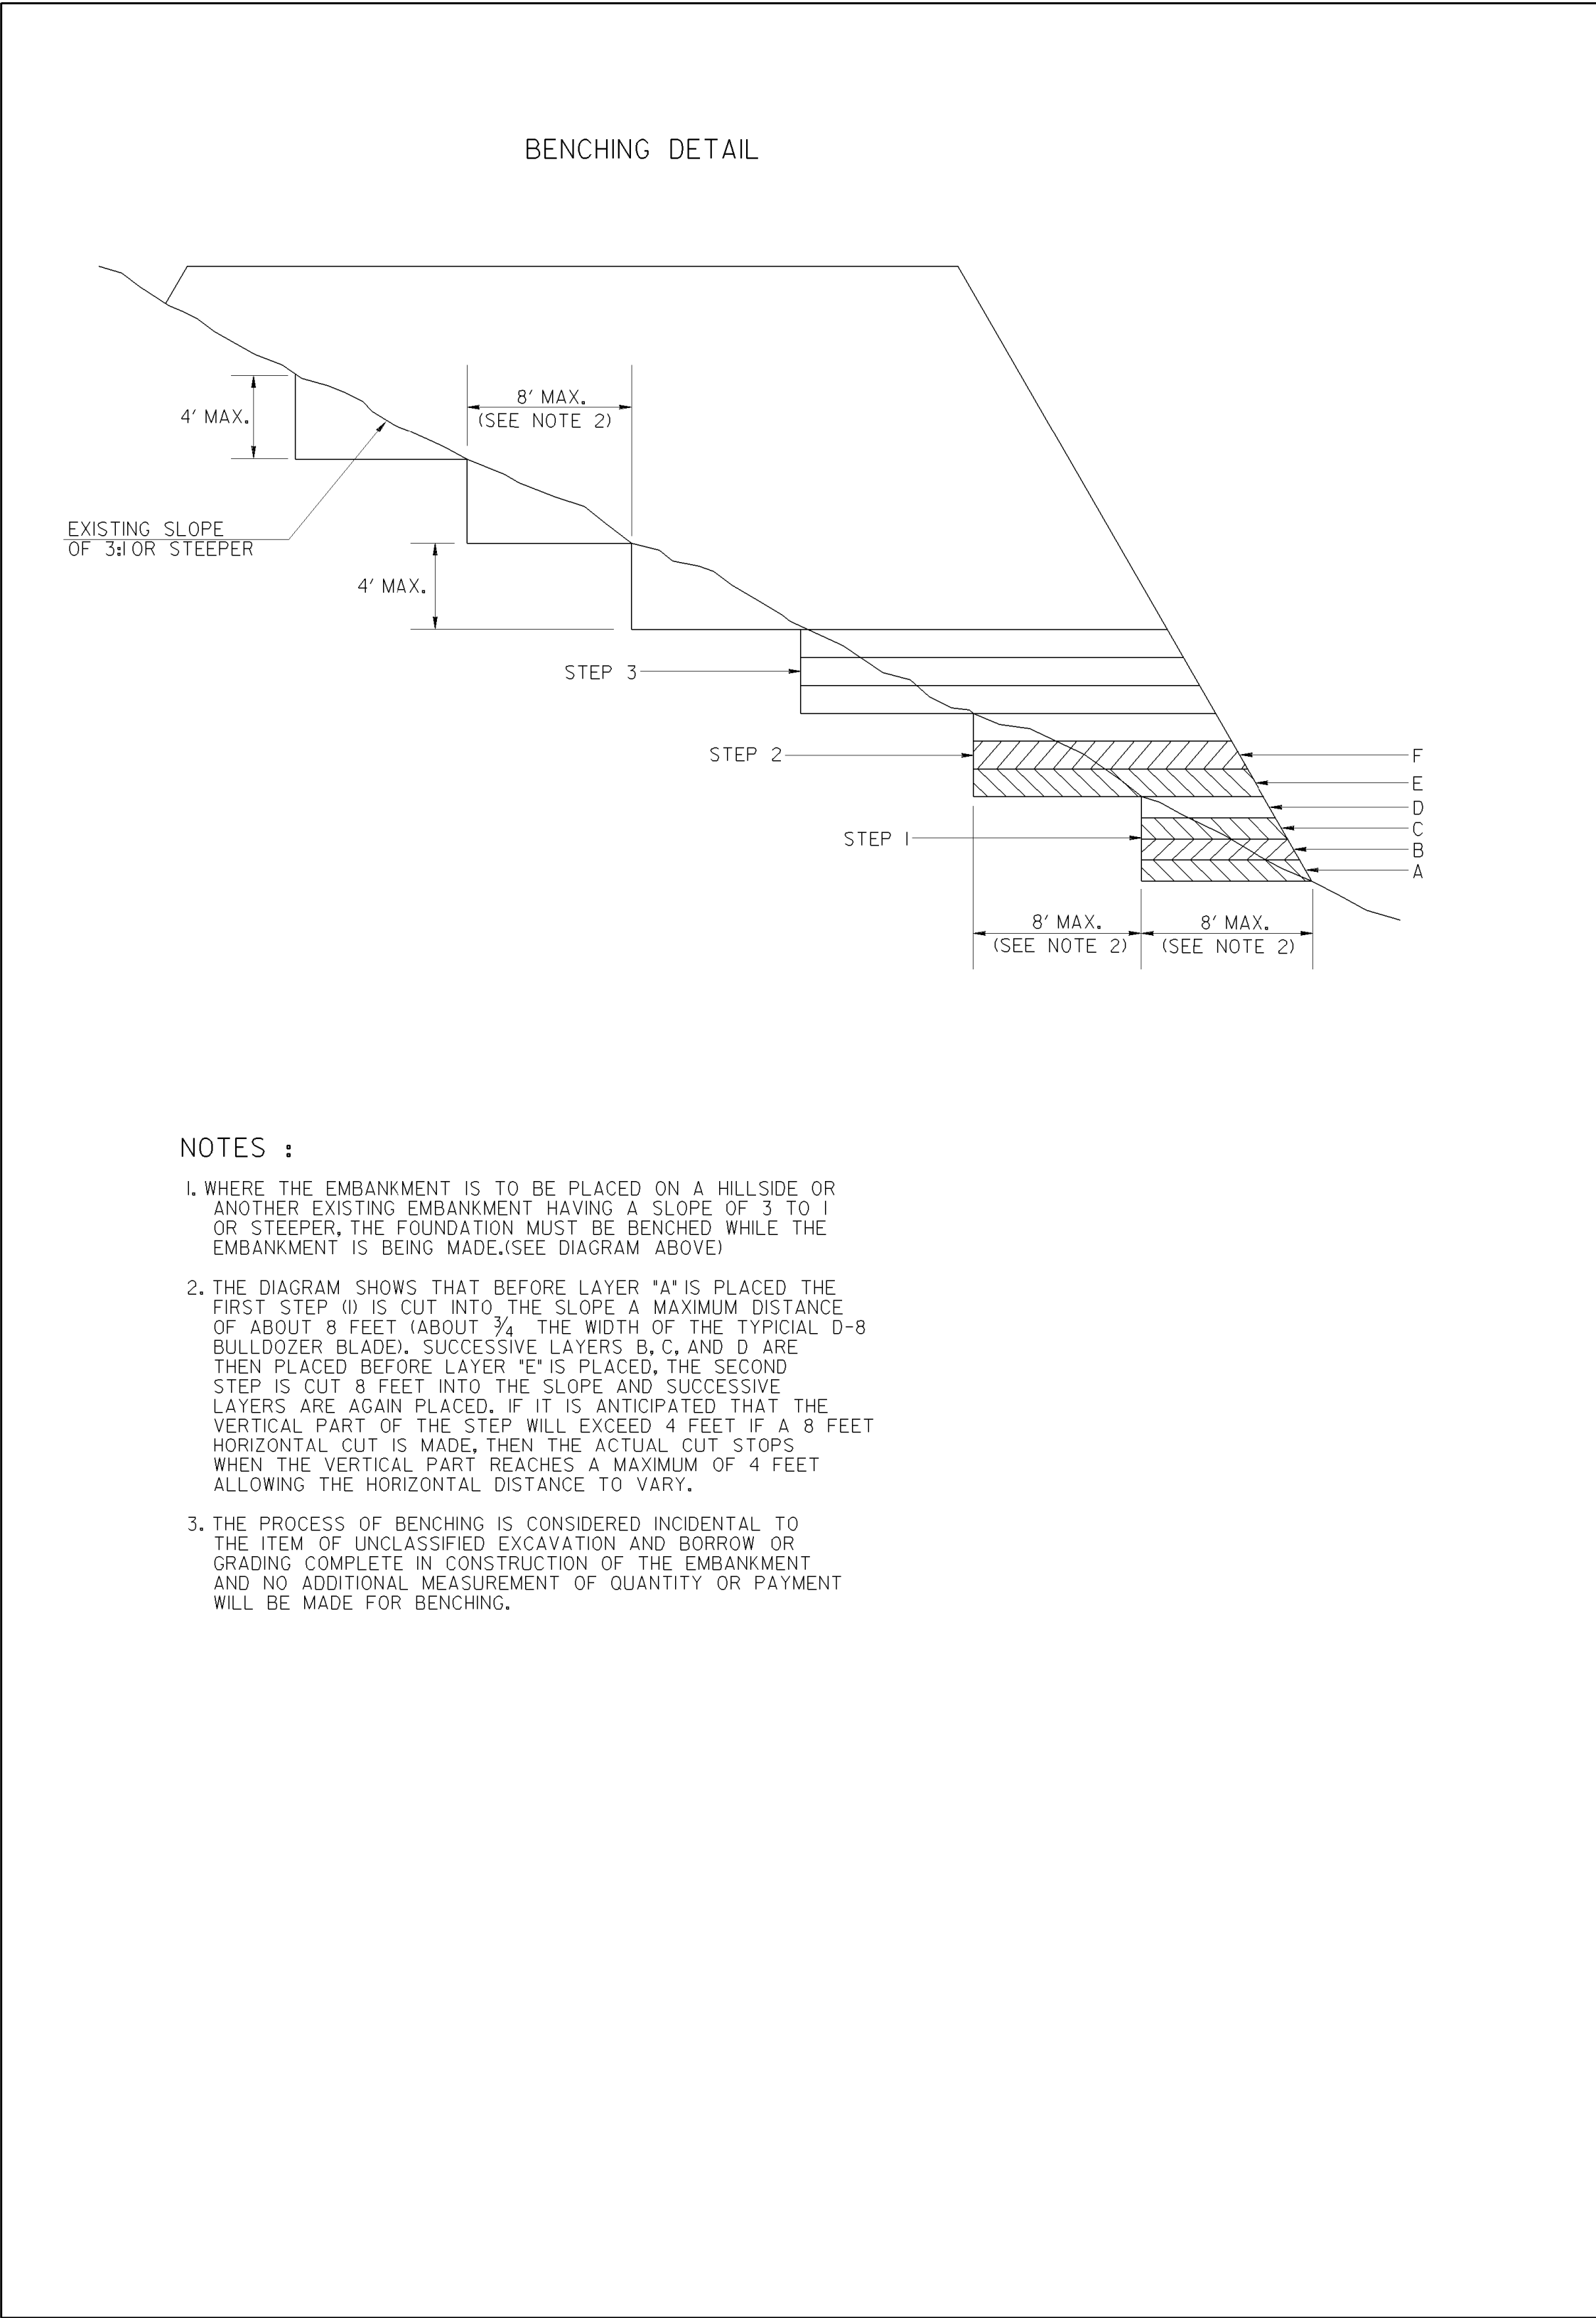

6/18/2009 7:38:27 PM \\GDOT-DSN\GDPLOT\DCP\go_tiff_output.qcf gowens V:\GARY\REVISED S-7\S-7.prp

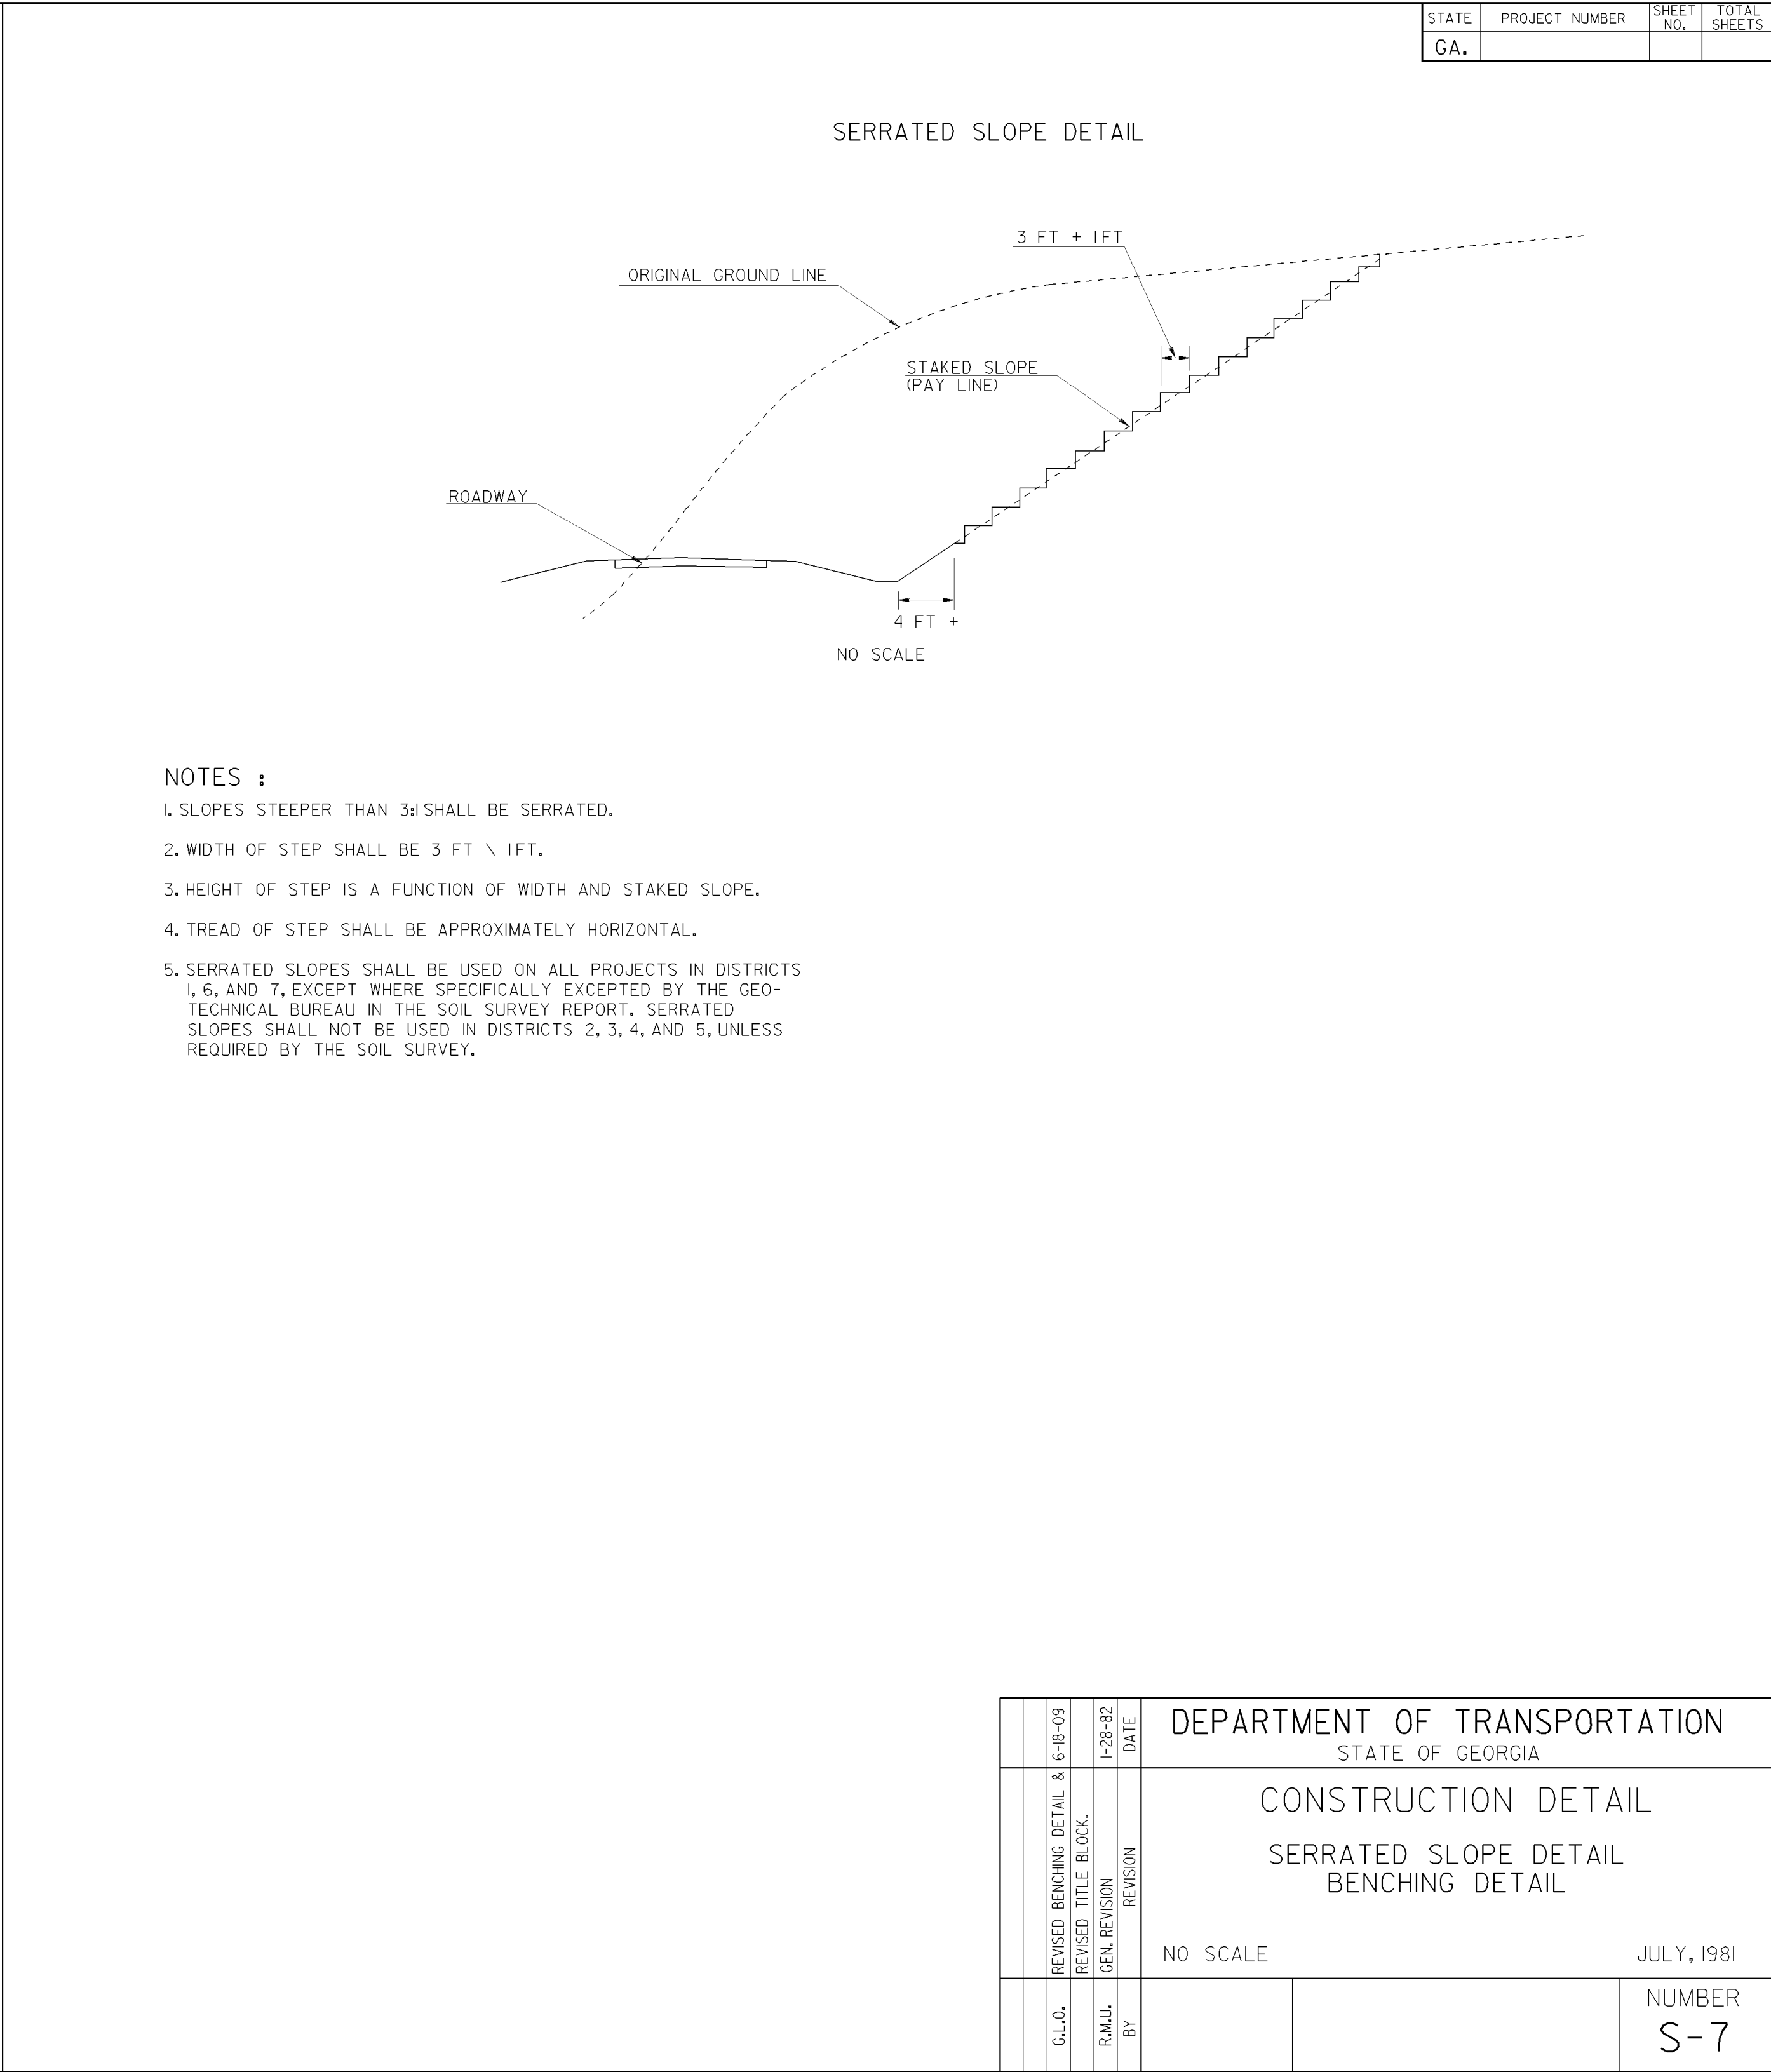

				DEPARTMENT OF TRANSPORTATION STATE OF GEORGIA
				CONSTRUCTION DETAIL SERRATED SLOPE DETAIL BENCHING DETAIL
				NO SCALE JULY, 1981
				NUMBER S-7